

Work Order ID 135584

Wednesday, August 12, 2015 4:04:59 PM

646.3315
D135584
REV. N/C3

135584

Page 1

Item ID: 646.3315

Accept

N900040100

Setup Start *NS1*

Revision ID:

Stop *NS2*

Item Name: Blade

Start Date: 8/12/15 Start Qty: 6.00 *6*

Cust Item ID:

Required Date: 8/12/15 Req'd Qty: 6.00 *6*

Customer:

Reference:

Approvals: Process Plan: MLJ Date: AUG 17 2015

Tooling:

Date:

Run Start *NR1*

QC: Date: SPC (Y/N):

Date:

Stop *NR2*

Sequence ID/ Work Center ID	Operation Description	Set Up/ Run Hours	Tool ID	Tool #	Plan Code	Accept Qty	Reject Qty	Reject Number	Insp. Stamp
--------------------------------	--------------------------	----------------------	---------	--------	--------------	---------------	---------------	------------------	----------------

Draw Nbr	Revision Nbr
646.3300	N/C3

100

0.00

100

BAND SAW

Bandsaw

Memo

0.00

Jeaspa Bandsaw

Cut Blank at 2.600"

6 0 15/29/02

110

0.01

110

HAAS CNC VERTICAL MACHINING #1

HAAS 1

Memo

0.03

HAAS CNC vertical machine #1

1-Machine per folio FB147

DWG REV: AA

FOLIO REV: N/C

2- deburr and break all sharp edges except otherwise noted

KNIFE EDGE MUST BE SHARPENED USING STONE, REMOVE ALL
BURRS ON CUTTING EDGE

6 0 15/29/04

DQA: _____ Date: _____



WORK ORDER NON-CONFORMANCE / UPDATE

QA Closed: _____ Date: _____

Work Order update only ☐

Work Order: _____ Part No. _____ NCR No. _____	DISPOSITION Rework ☐ Scrap ☐ Use-as-is ☐ Suspected Unapproved ☐	AGAINST DEPARTMENT/PROCESS Skid-tube ☐ Machining ☐ Thermoforming ☐ Large Fab ☐ Cross tube ☐ Small Fab ☐ Finishing ☐ Composite ☐ Water Jet ☐ Prod. Eng. Coord. ☐ Rec/Store/Packaging ☐ Supplier ☐ Engineering ☐ Quality ☐ Other ☐			
Date : _____	Step #: _____	QTY Effective : _____		MRB (QSI042) Approval	
Description Work Order Deviation			Disposition		
			Completed By		
			Lead hand / Supervisor Approval Verification		
			QC / QA Coordinator Approval		
Root Cause		FAULT CATEGORY			
Environment ☐ Design ☐ Doc/Data ☐ Equip/Tooling ☐ Handling/Pre ☐ Material ☐ Internal Transport ☐ Tribal Knowledge ☐ LOA ☐ Substation ☐ Past Expiry Date ☐ Misidentified ☐	No Re-verification ☐ Operator ☐ Offset/Setup ☐ Supplier ☐ Training ☐ Use for Testing ☐ Poor Information ☐ Rushing ☐ Product Improvement ☐ Process Improvement ☐ Manufacturing Process ☐ Past Due ☐	Pressure/Forced ☐ Bending ☐ Centre Not Concentric ☐ Cracks ☐ Crimp/Kink/Ripple/Wave ☐ Cuffs ☐ Crushing ☐ Heat Treat ☐ Wave/Twist in Tube ☐ Marks/Chatter ☐	Temperature/Cure ☐ Set-up ☐ BOM/Route ☐ Broken/Damage/Defect ☐ Inspection Incomplete/Unqualified ☐ Contamination ☐ Countersink ☐ Cut Too Short ☐ Instructions Incomplete/Unclear ☐ Drill Holes ☐	Power Loss/Surge ☐ Folio/Program ☐ Grain ☐ Weld ☐ Wrong Stock Pulled ☐ Out of Sequence ☐ Off-set ☐ Misabeled ☐ Fit/Function ☐ Misaligned/off center ☐	Positioned Wrong ☐ Outside Dimensions ☐ Over/Under tolerance ☐ Part Incorrect ☐ Part Lost/Missing ☐ Part Moved ☐ Drawing ☐ Finish ☐ Misread ☐ Turning Sequence ☐
OTHER : _____					

Work Order ID 135584

135584

Page 2

Wednesday, August 12, 2015 4:04:59 PM

Item ID: 646.3315 Accept ***N900040100*** Setup Start ***NS1***
 Revision ID: Stop ***NS2***
 Item Name: Blade
 Start Date: 8/12/15 Start Qty: 6.00 ***6*** Cust Item ID:
 Required Date: 8/12/15 Req'd Qty: 6.00 ***6*** Customer:
 Reference:

Approvals: Process Plan: _____ Date: _____ Tooling: _____ Date: _____ Run Start ***NR1***
 QC: _____ Date: _____ SPC (Y/N): _____ Date: _____ Stop ***NR2***

Sequence ID/ Work Center ID	Operation Description	Set Up/ Run Hours	Tool ID	Tool #	Plan Code	Accept Qty	Reject Qty	Reject Number	Insp. Stamp
120	QC2- Inspect parts off machine FAI/FAIB	0.00				6	0		15/09/03
120									
QC	Memo	0.00							
Quality Control									
130	QC8- Inspect parts - second check	0.00				6	0		DAS 14 9-89 15/09/08
130									
QC	Memo	0.00							
Quality Control									
140	Outsource process - Heat Treat	0.00				CL		SEP 09 2015	4
140									
Outsource1	Memo	24.00							
Outsource process - Heat Treat	HEAT TREAT AS PER DWG, SEE NOTE #3								
	ISSUE P/O: 29729								

DQA: _____ Date: _____



WORK ORDER NON-CONFORMANCE / UPDATE

QA Closed: _____ Date: _____

Work Order update only ☐

Work Order: _____ Part No. _____ NCR No. _____	DISPOSITION Rework ☐ Scrap ☐ Use-as-is ☐ Suspected Unapproved ☐	AGAINST DEPARTMENT/PROCESS Skid-tube ☐ Machining ☐ Thermoforming ☐ Large Fab ☐ Cross tube ☐ Small Fab ☐ Finishing ☐ Composite ☐ Water Jet ☐ Prod. Eng. Coord. ☐ Rec/Store/Packaging ☐ Supplier ☐ Engineering ☐ Quality ☐ Other ☐			
Date :	Step #:	QTY Effective :		MRB (QSI042) Approval	
Description Work Order Deviation			Disposition		
			Completed By		
			Lead hand / Supervisor Approval Verification		
			QC / QA Coordinator Approval		
Root Cause Environment ☐ Design ☐ Doc/Data ☐ Equip/Tooling ☐ Handling/Pre ☐ Material ☐ Internal Transport ☐ Tribal Knowledge ☐ LOA ☐ Substation ☐ Past Expiry Date ☐ Misidentified ☐ No Re-verification ☐ Operator ☐ Offset/Setup ☐ Supplier ☐ Training ☐ Use for Testing ☐ Poor Information ☐ Rushing ☐ Product Improvement ☐ Process Improvement ☐ Manufacturing Process ☐ Past Due ☐		FAULT CATEGORY Pressure/Forced ☐ Bending ☐ Centre Not Concentric ☐ Cracks ☐ Crimp/Kink/Ripple/Wave ☐ Cuffs ☐ Crushing ☐ Heat Treat ☐ Wave/Twist in Tube ☐ Marks/Chatter ☐ Temperature/Cure ☐ Set-up ☐ BOM/Route ☐ Broken/Damage/Defect ☐ Inspection Incomplete/Unqualified ☐ Contamination ☐ Countersink ☐ Cut Too Short ☐ Instructions Incomplete/Unclear ☐ Drill Holes ☐ Power Loss/Surge ☐ Folio/Program ☐ Grain ☐ Weld ☐ Wrong Stock Pulled ☐ Out of Sequence ☐ Off-set ☐ Misabeled ☐ Fit/Function ☐ Misaligned/off center ☐ Positioned Wrong ☐ Outside Dimensions ☐ Over/Under tolerance ☐ Part Incorrect ☐ Part Lost/Missing ☐ Part Moved ☐ Drawing ☐ Finish ☐ Misread ☐ Turning Sequence ☐			
OTHER : _____					

Work Order ID 135584

135584

Page 3

Item ID: 646.3315

Accept

N900040100

Setup Start ***NS1***

Revision ID:

Item Name: Blade

Stop ***NS2***

Start Date: 8/12/15 Start Qty: 6.00 ***6***

Cust Item ID:

Required Date: 8/12/15 Req'd Qty: 6.00 ***6***

Customer:

Reference:

Approvals: Process Plan: _____ Date: _____ Tooling: _____ Date: _____

Run Start ***NR1***

QC: _____ Date: _____ SPC (Y/N): _____ Date: _____

Stop ***NR2***

Sequence ID/ Work Center ID	Operation Description	Set Up/ Run Hours	Tool ID	Tool #	Plan Code	Accept Qty	Reject Qty	Reject Number	Insp. Stamp
150	Receive & Inspect for Damage & Mat'l Certs	0.00				6			
150									
Packaging	Memo	0.00							
Packaging									
155	QC5- Inspect part completeness to step on W/O	0.00							
155									
QC	Memo	0.00							
Quality Control									
160	Spray Painting per QSI005 4.2	0.00							
160									
SprayPaint	Memo	0.00							
Spray Painting	PRIME AS PER DWG, SEE NOTE #4								
	PRIMER BATCH: <u>131277</u>								

DAS
66
9-89

SEP 15 2015

DAS
38
9-89

SEP 16 2015

DAS
41
9-89

15-9-18

DQA: _____ Date: _____



WORK ORDER NON-CONFORMANCE / UPDATE

QA Closed: _____ Date: _____

Work Order update only ☐

Work Order: _____ Part No. _____ NCR No. _____	DISPOSITION Rework ☐ Scrap ☐ Use-as-is ☐ Suspected Unapproved ☐	AGAINST DEPARTMENT/PROCESS Skid-tube ☐ Machining ☐ Thermoforming ☐ Large Fab ☐ Cross tube ☐ Small Fab ☐ Finishing ☐ Composite ☐ Water Jet ☐ Prod. Eng. Coord. ☐ Rec/Store/Packaging ☐ Supplier ☐ Engineering ☐ Quality ☐ Other ☐			
Date :	Step #:	QTY Effective :		MRB (QSI042) Approval	
Description Work Order Deviation			Disposition		
			Completed By		
			Lead hand / Supervisor Approval Verification		
			QC / QA Coordinator Approval		
Root Cause		FAULT CATEGORY			
Environment ☐ Design ☐ Doc/Data ☐ Equip/Tooling ☐ Handling/Pre ☐ Material ☐ Internal Transport ☐ Tribal Knowledge ☐ LOA ☐ Substation ☐ Past Expiry Date ☐ Misidentified ☐	No Re-verification ☐ Operator ☐ Offset/Setup ☐ Supplier ☐ Training ☐ Use for Testing ☐ Poor Information ☐ Rushing ☐ Product Improvement ☐ Process Improvement ☐ Manufacturing Process ☐ Past Due ☐	Pressure/Forced ☐ Bending ☐ Centre Not Concentric ☐ Cracks ☐ Crimp/Kink/Ripple/Wave ☐ Cuffs ☐ Crushing ☐ Heat Treat ☐ Wave/Twist in Tube ☐ Marks/Chatter ☐	Temperature/Cure ☐ Set-up ☐ BOM/Route ☐ Broken/Damage/Defect ☐ Inspection Incomplete/Unqualified ☐ Contamination ☐ Countersink ☐ Cut Too Short ☐ Instructions Incomplete/Unclear ☐ Drill Holes ☐	Power Loss/Surge ☐ Folio/Program ☐ Grain ☐ Weld ☐ Wrong Stock Pulled ☐ Out of Sequence ☐ Off-set ☐ Misabeled ☐ Fit/Function ☐ Misaligned/off center ☐	Positioned Wrong ☐ Outside Dimensions ☐ Over/Under tolerance ☐ Part Incorrect ☐ Part Lost/Missing ☐ Part Moved ☐ Drawing ☐ Finish ☐ Misread ☐ Turning Sequence ☐
OTHER : ☐					

Work Order ID 135584

135584

Page 4

Wednesday, August 12, 2015 4:04:59 PM

Item ID: 646.3315 Accept ***N900040100*** Setup Start ***NS1***
 Revision ID: Stop ***NS2***
 Item Name: Blade
 Start Date: 8/12/15 Start Qty: 6.00 ***6*** Cust Item ID:
 Required Date: 8/12/15 Req'd Qty: 6.00 ***6*** Customer:
 Reference:

Approvals: Process Plan: _____ Date: _____ Tooling: _____ Date: _____ Run Start ***NR1***
 QC: _____ Date: _____ SPC (Y/N): _____ Date: _____ Stop ***NR2***

Sequence ID/ Work Center ID	Operation Description	Set Up/ Run Hours	Tool ID	Tool #	Plan Code	Accept Qty	Reject Qty	Reject Number	Insp. Stamp
170	QC14- Inspect Spray Paint	0.00							
170									DAS
QC	Memo	0.00							38
Quality Control									9-89
									SEP 21 2015
180	Identify as per dwg & Stock Location: <u>GA</u>	0.00							
180									DAS
Packaging	Memo	0.00							30
Packaging	***IDENTIFY AS PER APICAL MPP-120 BY STAMPING P# AND REV***								9-89
									SEP 21 2015
190	QC21- Final Inspection - Work Order Release	0.00							
190									
QC	Memo	0.01							
Quality Control									

SEP 20 15 09 21

DQA: _____ Date: _____



WORK ORDER NON-CONFORMANCE / UPDATE

QA Closed: _____ Date: _____

Work Order update only ☐

Work Order: _____ Part No. _____ NCR No. _____		DISPOSITION Rework ☐ Scrap ☐ Use-as-is ☐ Suspected Unapproved ☐		AGAINST DEPARTMENT/PROCESS Skid-tube ☐ Machining ☐ Thermoforming ☐ Large Fab ☐ Cross tube ☐ Small Fab ☐ Finishing ☐ Composite ☐ Water Jet ☐ Prod. Eng. Coord. ☐ Rec/Store/Packaging ☐ Supplier ☐ Engineering ☐ Quality ☐ Other ☐					
Date :		Step #:		QTY Effective :			MRB (QS1042) Approval		
Description Work Order Deviation				Disposition				Completed By	
								Lead hand / Supervisor Approval Verification	
								QC / QA Coordinator Approval	
Root Cause		FAULT CATEGORY							
Environment ☐	No Re-verification ☐	Pressure/Forced ☐	Temperature/Cure ☐	Power Loss/Surge ☐	Positioned Wrong ☐				
Design ☐	Operator ☐	Bending ☐	Set-up ☐	Folio/Program ☐	Outside Dimensions ☐				
Doc/Data ☐	Offset/Setup ☐	Centre Not Concentric ☐	BOM/Route ☐	Grain ☐	Over/Under tolerance ☐				
Equip/Tooling ☐	Supplier ☐	Cracks ☐	Broken/Damage/Defect ☐	Weld ☐	Part Incorrect ☐				
Handling/Pre ☐	Training ☐	Crimp/Kink/Ripple/Wave ☐	Inspection Incomplete/Unqualified ☐	Wrong Stock Pulled ☐	Part Lost/Missing ☐				
Material ☐	Use for Testing ☐	Cuffs ☐	Contamination ☐	Out of Sequence ☐	Part Moved ☐				
Internal Transport ☐	Poor Information ☐	Crushing ☐	Countersink ☐	Off-set ☐	Drawing ☐				
Tribal Knowledge ☐	Rushing ☐	Heat Treat ☐	Cut Too Short ☐	Mislabeled ☐	Finish ☐				
LOA ☐	Product Improvement ☐	Wave/Twist in Tube ☐	Instructions Incomplete/Unclear ☐	Fit/Function ☐	Misread ☐				
Substation ☐	Process Improvement ☐	Marks/Chatter ☐	Drill Holes ☐	Misaligned/off center ☐	Turning Sequence ☐				
Past Expiry Date ☐	Manufacturing Process ☐	OTHER :							
Misidentified ☐	Past Due ☐								

Picklist Print

Wednesday, August 12, 2015 4:04:58 PM

Page 1

Work Order ID: 135584

135584

Parent Item: 646.3315

646.3315

Parent Item Name: Blade

Start Date: 8/12/15

Required Date: 8/12/15

Start Qty: 6.00

Required Qty: 6.00

Comments: IPP REV:A NEW ISSUE 12/11/07 JFS VERIFY BY: JLM

Component Item ID/ Item Name	Replacement Item ID	Mfg/ Purch	Bin Item	Primary Location	Last Location	Route Seq ID	Unit of Measure	Qty on Hand	Qty per Kit	Total Qty	Qty Issued	Date Issued	Status
MSTEEL-A2- B0.500X1.250		Purchased		No		100	f	142.4520	0.217	1.370526			

MSTFFI -A2-B0 500X1 250

AISI A2 TOOL STEEL BAR, 0.500 X 1.250

15/09/02

<u>Location</u>	<u>Loc Qty</u>	<u>Loc Code</u>
MAT010	142.452	
M126438	5.452	
M127494	9	
M131783	128	

~~1.370526~~
~~1.370526~~
~~1.370526~~

1.552'

DQA: _____ Date: _____



WORK ORDER NON-CONFORMANCE / UPDATE

QA Closed: _____ Date: _____

Work Order update only ☐

Work Order: _____ Part No. _____ NCR No. _____	DISPOSITION Rework ☐ Scrap ☐ Use-as-is ☐ Suspected Unapproved ☐	AGAINST DEPARTMENT/PROCESS Skid-tube ☐ Machining ☐ Thermoforming ☐ Large Fab ☐ Cross tube ☐ Small Fab ☐ Finishing ☐ Composite ☐ Water Jet ☐ Prod. Eng. Coord. ☐ Rec/Store/Packaging ☐ Supplier ☐ Engineering ☐ Quality ☐ Other ☐			
Date : _____	Step #: _____	QTY Effective : _____		MRB (QS1042) Approval	
Description Work Order Deviation		Disposition		Completed By	
				Lead hand / Supervisor Approval Verification	
				QC / QA Coordinator Approval	
Root Cause		FAULT CATEGORY			
Environment ☐ Design ☐ Doc/Data ☐ Equip/Tooling ☐ Handling/Pre ☐ Material ☐ Internal Transport ☐ Tribal Knowledge ☐ LOA ☐ Substation ☐ Past Expiry Date ☐ Misidentified ☐	No Re-verification ☐ Operator ☐ Offset/Setup ☐ Supplier ☐ Training ☐ Use for Testing ☐ Poor Information ☐ Rushing ☐ Product Improvement ☐ Process Improvement ☐ Manufacturing Process ☐ Past Due ☐	Pressure/Forced ☐ Bending ☐ Centre Not Concentric ☐ Cracks ☐ Crimp/Kink/Ripple/Wave ☐ Cuffs ☐ Crushing ☐ Heat Treat ☐ Wave/Twist in Tube ☐ Marks/Chatter ☐	Temperature/Cure ☐ Set-up ☐ BOM/Route ☐ Broken/Damage/Defect ☐ Inspection Incomplete/Unqualified ☐ Contamination ☐ Countersink ☐ Cut Too Short ☐ Instructions Incomplete/Unclear ☐ Drill Holes ☐	Power Loss/Surge ☐ Folio/Program ☐ Grain ☐ Weld ☐ Wrong Stock Pulled ☐ Out of Sequence ☐ Off-set ☐ Misabeled ☐ Fit/Function ☐ Misaligned/off center ☐	Positioned Wrong ☐ Outside Dimensions ☐ Over/Under tolerance ☐ Part Incorrect ☐ Part Lost/Missing ☐ Part Moved ☐ Drawing ☐ Finish ☐ Misread ☐ Turning Sequence ☐
OTHER : _____					

APICAL

INDUSTRIES, INC.

ENGINEERING CHANGE NOTICE NO.

04765

SHEET 1 OF 1

DWG NO. 646.3300

REV: NC

PREPARED BY J. SOTO

DATE: 12/08/2014

EFFECT ON DWG
☐ INC. ☒ UNINC.

DWG TITLE: UPPER CUTTER ASSY

APPROVED BY: ENGR. *[Signature]*

MFG. *[Signature]*

QC *[Signature]*

EFF. NEXT ORDER

TRANSACTION CODES (TC):
A-ADD
R-REVISE
C-CREATE
D-DELETE



REASON: ADDED HOLE DIMENSION TO 646.3313.

SHEET 5 IS:

STOP COPY
RETURN TO
ENGINEERING
UNCONTROLLED COPY
SUBJECT TO AMENDMENT
WITHOUT NOTICE
WORK ORDER
NO. 135584 MJS

15-08-17

IS

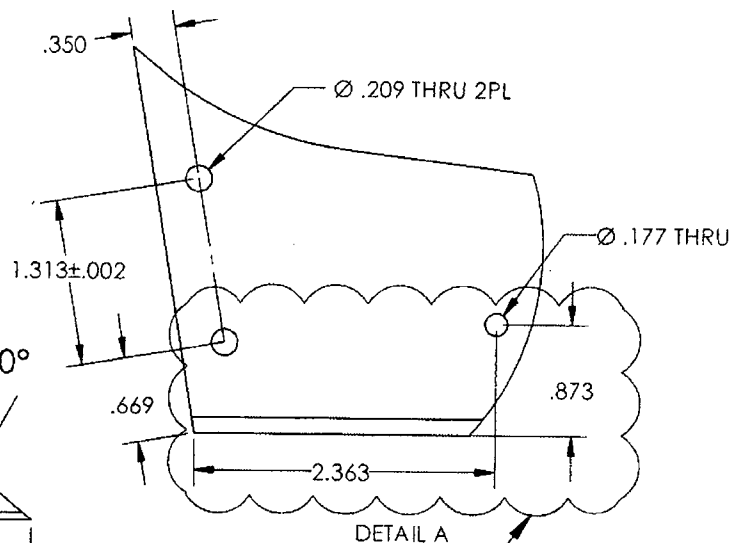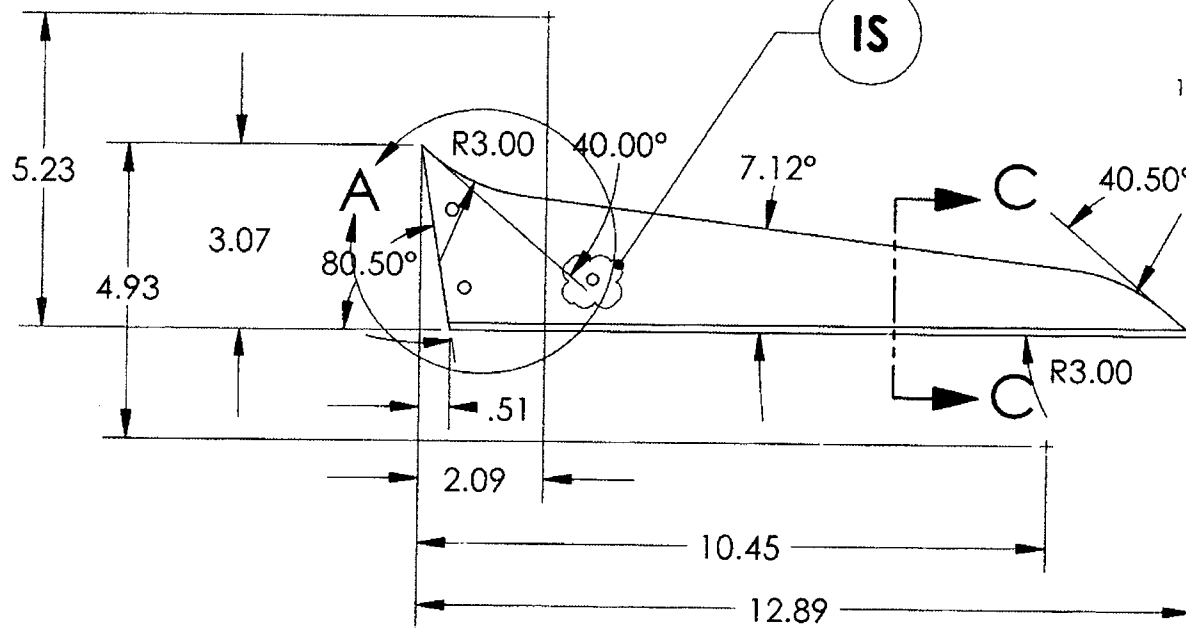

IS

DOCUMENTS EFFECTED:

☐ MDL ☐ INSTALL INSTRUCTIONS ☐ ICA ☐ FMS ☐ BOM

CHANGE CATEGORY

☐ MAJOR ☒ MINOR

DER REVIEW REQUIRED

☐ YES ☒ NO

APICAL
INDUSTRIES, INC.

ENGINEERING CHANGE NOTICE NO. 03724

SHEET 1 OF 1

DWG NO. 646.3300

REV: N/C

PREPARED
BY B. PETERS

DATE: 12/05/12

EFFECT ON DWG
☐ INC. ☒ UNINC.

DWG TITLE: UPPER CUTTER ASSY

APPROVED BY: ENGR

MFG

QC


EFF: NEXT ORDER

TRANSACTION CODES (C):
A-ADD C-CREATE
R-REVISE D-DELETE

REASON:

REVISED ORDINATE DIMENSION.

ECR:
D-12-025

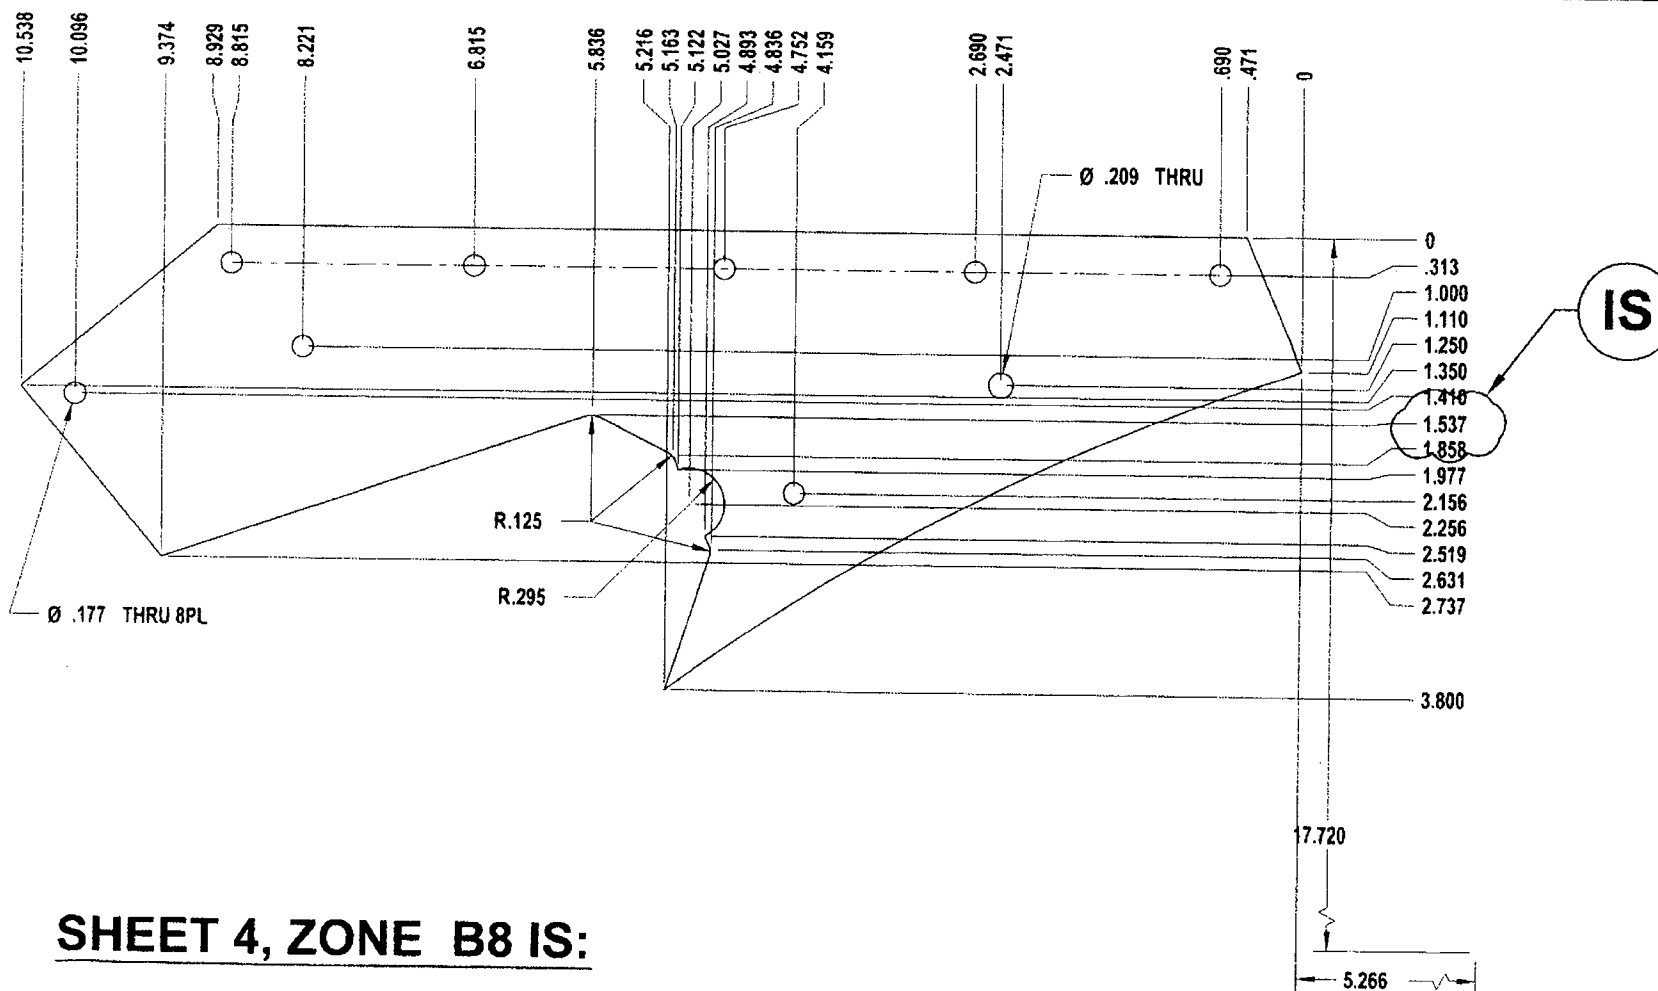

SHEET 4, ZONE B8 IS:

DOCUMENTS EFFECTED:

☐ RFMS ☐ MDL ☐ INSTALL INSTRU ☐ ICA ☐ BOM

CHANGE CATEGORY
☐ MAJOR ☒ MINOR


DER REVIEW REQUIRED
☐ YES ☒ NO

APICAL
INDUSTRIES, INC.

ENGINEERING CHANGE NOTICE NO. 02196		SHEET 1 OF 2	
DWG NO. 646.3300	REV: N/C	PREPARED BY S. HUFF	DATE: 01/05/09
DWG TITLE: UPPER CUTTER ASSY		EFFECT ON DWG ☐ INC. ☒ UNINC.	
APPROVED BY: ENGR <i>[Signature]</i>	MFG <i>[Signature]</i>	QC <i>[Signature]</i>	EFF: NEXT ORDER
REASON: REMOVED RIVETS IN FAVOR OF ADDITIONAL SCREWS			


TRANSACTION CODES (TC):
A-ADD C-CREATE
R-REVISE D-DELETE

SHEET 1, VIEW 646.3301, IS:

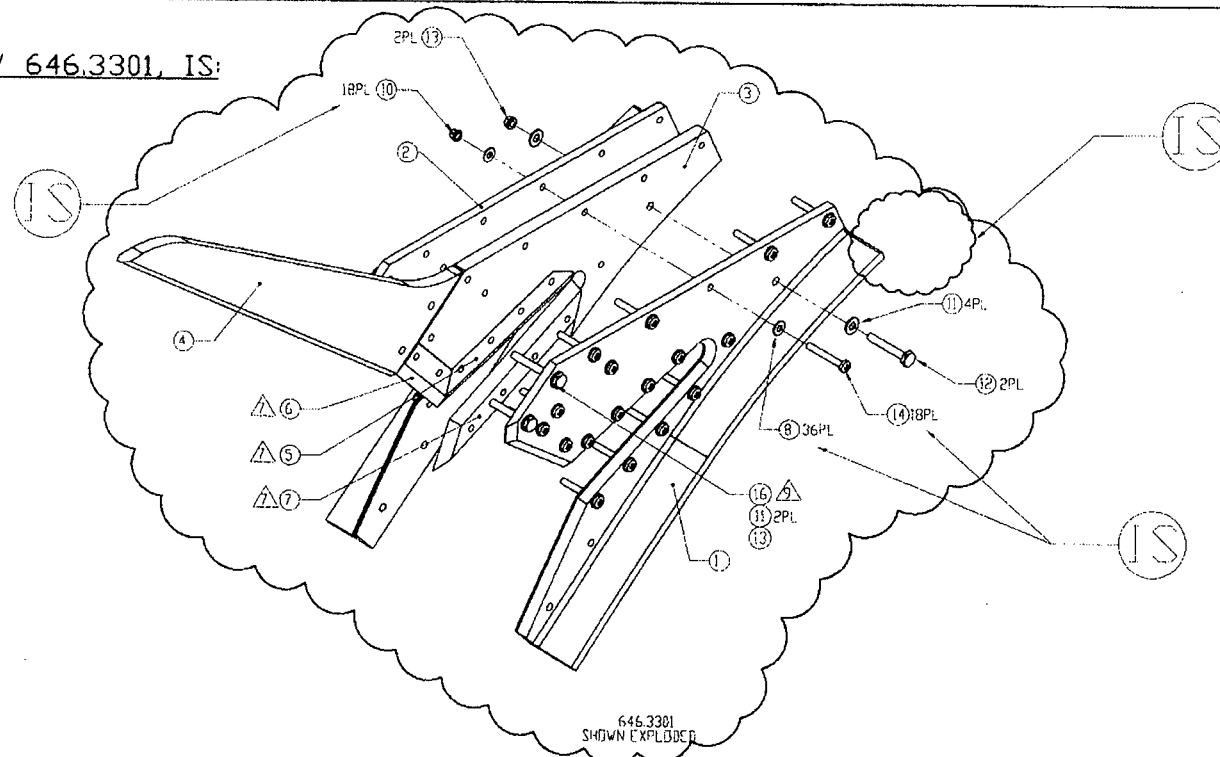

14	R	601.2765		18	SCREW	MS27039-0819
10	R	601.1541		18	LOCKNUT	MS21042L08
9	D	601.2766		3	RIVET	MS20470AD5-18
8	R	601.2764		36	WASHER	NAS1149FN832P
				.3301		
F/N	TC	PART NUMBER	QTY	DESCRIPTION		MATERIAL/SPECIFICATION
DOCUMENTS EFFECTED:						CHANGE CATEGORY
☐ MDL ☒ INSTALL INSTRU ☒ ICA ☐ FMS ☒ BOM						DER REVIEW REQUIRED
						☐ MAJOR ☒ MINOR
						☐ YES ☒ NO

SHEET 3, SECTION VIEW A-A, IS:

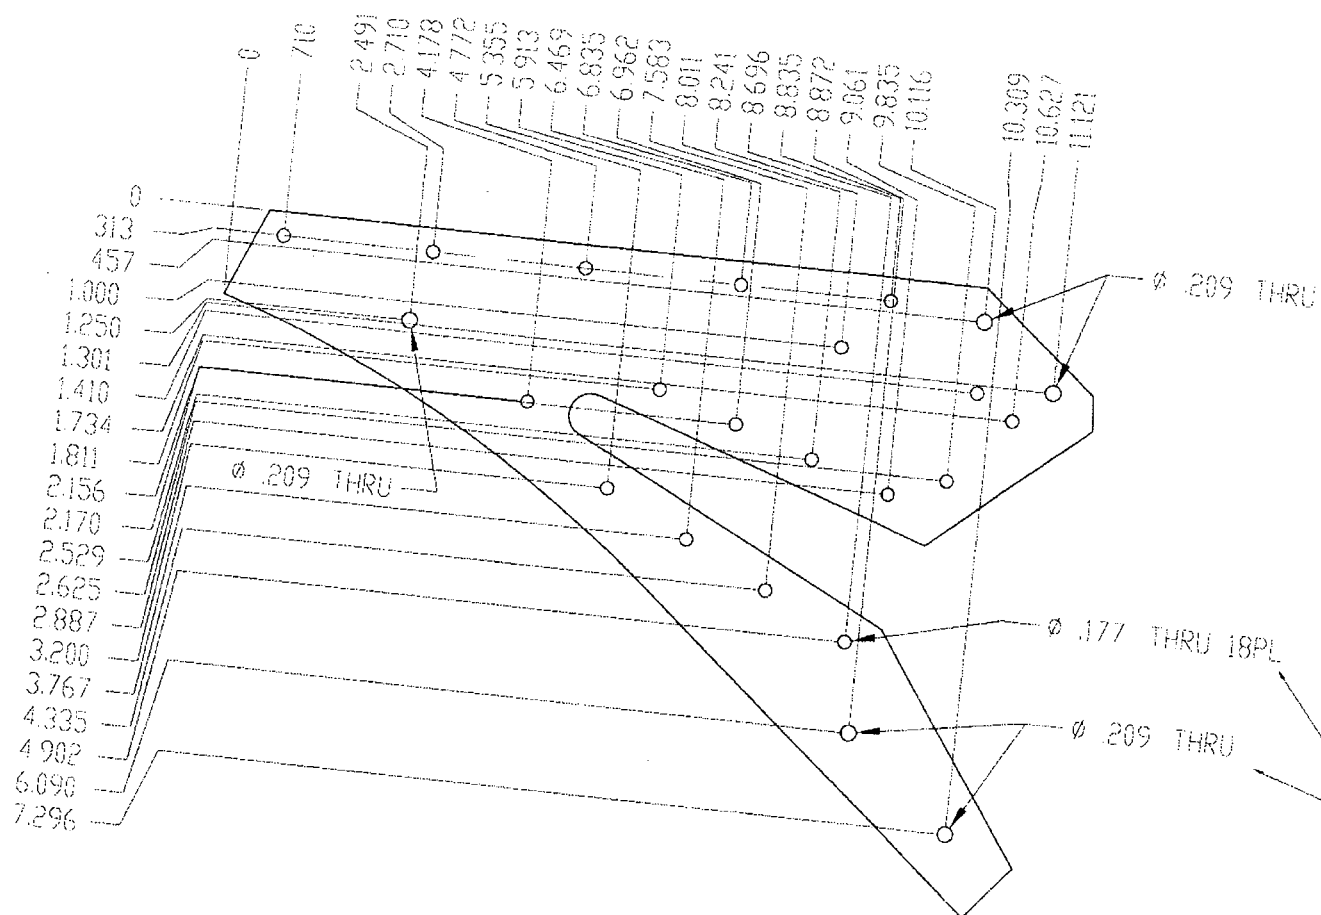


SECTION A-A

C PART NUMBER	QTY	DESCRIPTION	MATERIAL/SPECIFICATION
---------------	-----	-------------	------------------------

NO INFORMATION CONTAINED IN THIS DRAWING IS THE SOLE PROPERTY OF APICAL INDUSTRIES AND REPRODUCING IN PART OR WHOLE WITHOUT THE WRITTEN PERMISSION OF APICAL INDUSTRIES IS PROHIBITED.

REV	DESCRIPTION	DATE	APPROVED

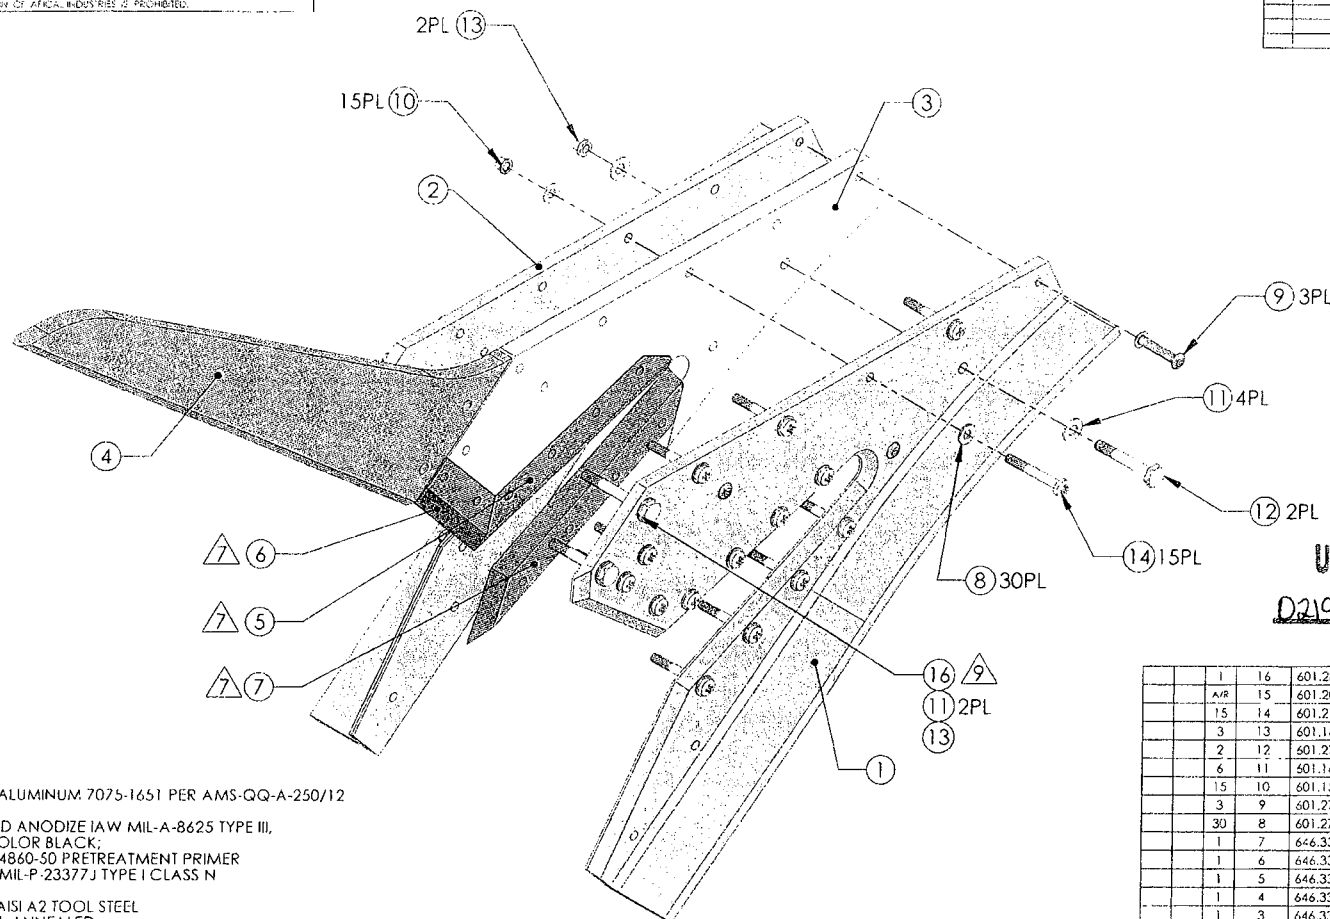

UNINCORPORATED ECN(S)

02196, 03724, 04765

NOTES:

- 1 MATERIAL: ALUMINUM 7075-1651 PER AMS-QQ-A-250/12
- 2 FINISH: HARD ANODIZE IAW MIL-A-8625 TYPE III, CLASS 2, COLOR BLACK; CARDINAL 4860-50 PRETREATMENT PRIMER PRIME IAW MIL-P-23377J TYPE I CLASS N
- 3 MATERIAL: AISI A2 TOOL STEEL CONDITION: ANNEALED POST PROCESS: HEAT TREAT TO 58-62 Rc ROCKWELL HARDNESS
- 4 FINISH: PRIME IAW MIL-P-23377J TYPE I CLASS N
- 5 DEBURR AND BREAK ALL SHARP EDGES EXCEPT WHERE OTHERWISE NOTED
- 6 IDENTIFY IAW MPP-120
- 7 APPLY F/N 15 AS REQUIRED TO ALL FAYING SURFACES OF F/N 5, 6 & 7 UPON ASSEMBLY
- 8 CUTTING EDGE INTENDED TO BE SHARP, DO NOT BREAK SHARP EDGE
- 9 INSTALL FASTENER FINGER-TIGHT

646.3301
SHOWN EXPLODED

QTY	FIN #	PART #	DESCRIPTION	MAT'L	SPEC.
1	16	601.2834	BOLT	AN3-14A	
15	15	601.2045	RTV, LOCITE 598		
15	14	601.2765	SCREW	M52703H-0014	
3	13	601.1624	LOCKNUT	M52703H-0014	
2	12	601.2763	BOLT	AN3-12A	
6	11	601.1607	WASHER	M52703H-0014	
15	10	601.1541	LOCKNUT	M52703H-0014	
3	9	601.2766	RIVET	M52703H-0014	
30	8	601.2764	WASHER	M52703H-0014	
1	7	646.3316	BLADE		
1	6	646.3315	BLADE		
1	5	646.3314	BLADE		
1	4	646.3313	UPPER GUIDE		
1	3	646.3312	CENTER PLATE		
1	2	646.3311	RH HALF		
1	1	646.3310	LH HALF		
1	1	646.3301	UPPER CUTTER ASSY		

APICAL INDUSTRIES

2608 TEMPLE HEIGHTS DR.
OCEANSIDE, CA. 92056-3512 (760)724-5300

UPPER CUTTER ASSY

SCALE: NONE 1 SHEET 1 OF 8


ALL INFORMATION CONTAINED HEREIN IS THE PROPERTY OF APICAL INDUSTRIES AND REPRODUCTION IN PART OR WHOLE WITHOUT THE WRITTEN PERMISSION OF APICAL INDUSTRIES IS PROHIBITED.

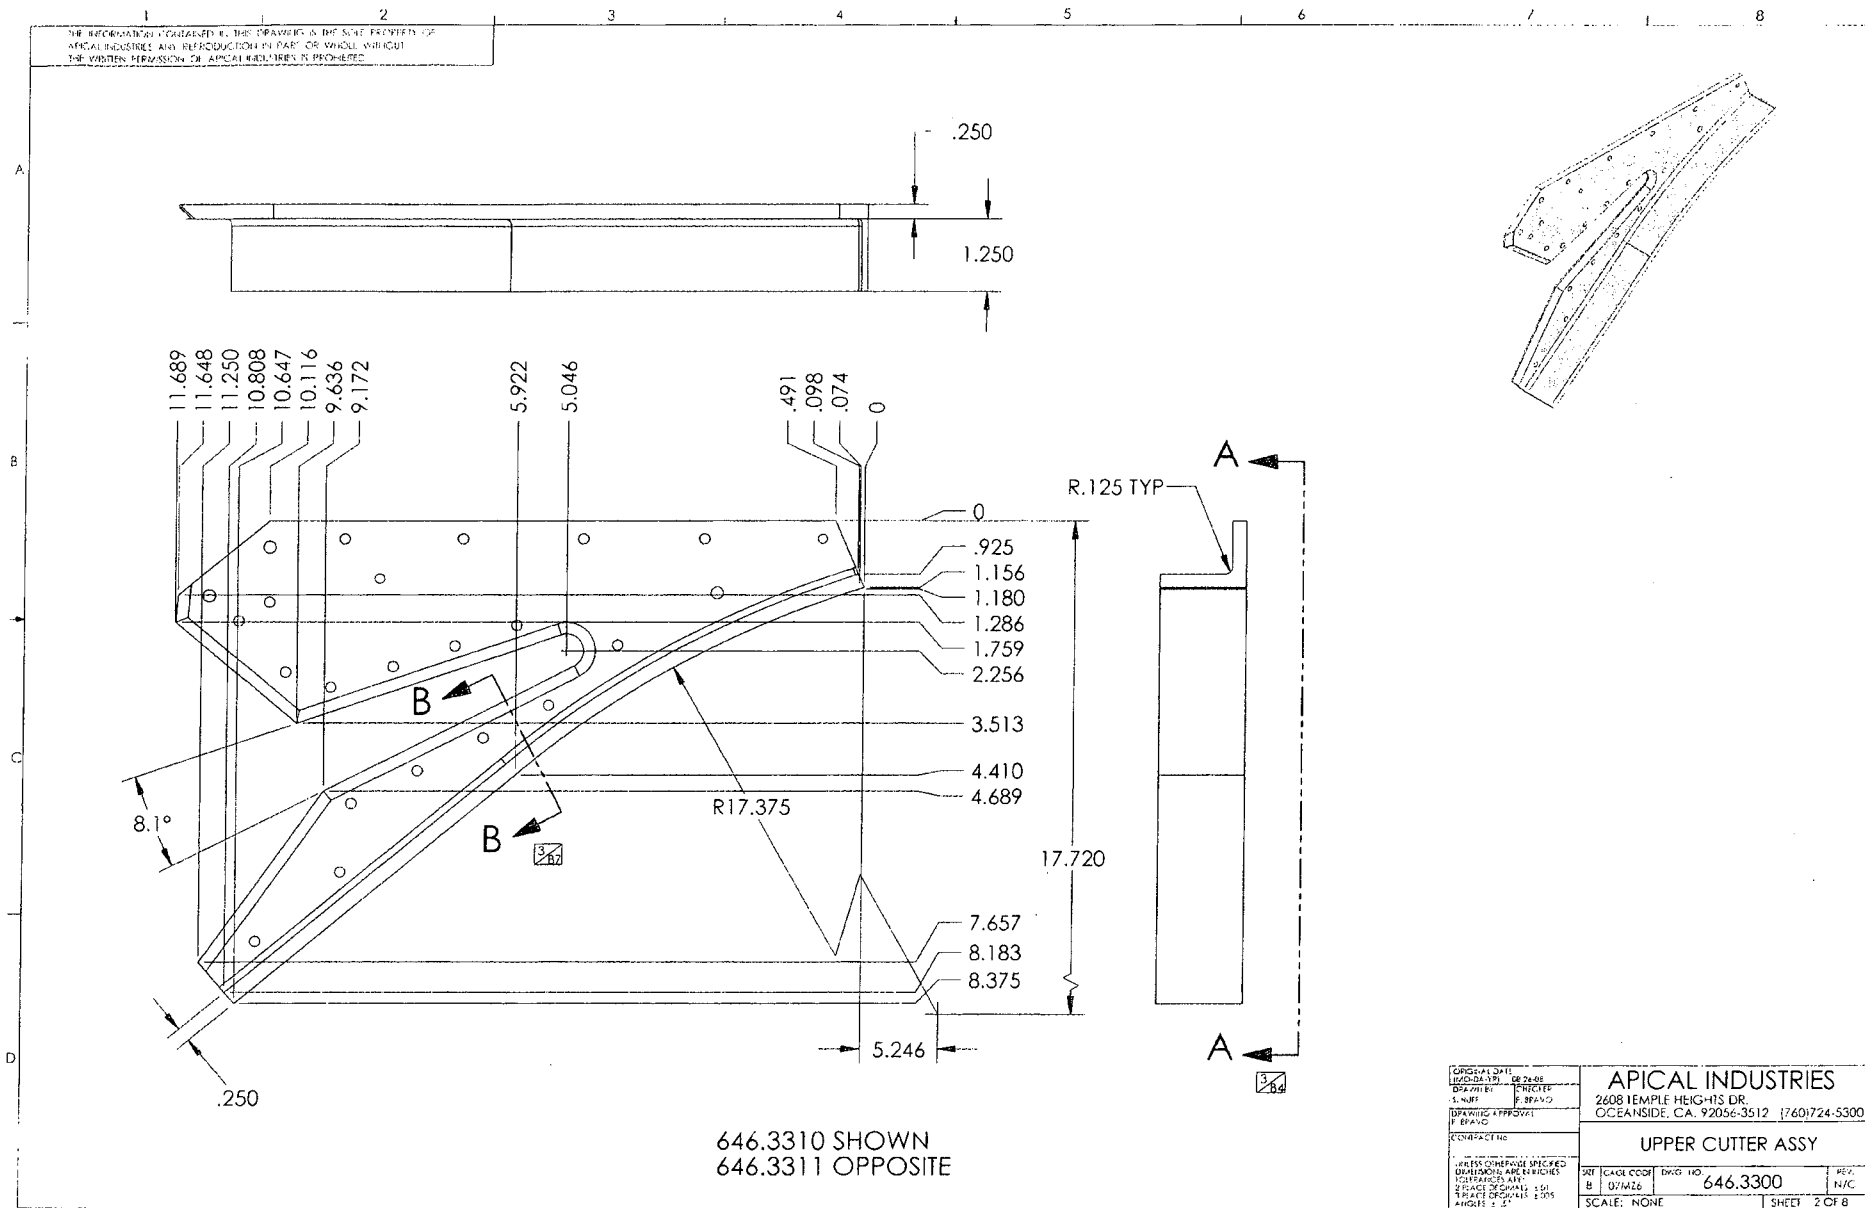


ORIGINAL DATE: 01/01/01 BY: 24-01		APICAL INDUSTRIES	
DRAWN BY: ENIGER		2608 TEMPLE HEIGHTS DR.	
CHECKED BY: P. BRANC		OCEANSIDE, CA 92056-3512 (760) 724-5300	
DRAWING APPROVED BY: P. BRANC		UPPER CUTTER ASSY	
CONTRACT NO.		SCALE: NONE	
APICAL INDUSTRIES SPECIFIED DIMENSIONS ARE IN INCHES UNLESS OTHERWISE SPECIFIED		DATE: 01/01/01	REV: N/C
TOLERANCES ARE:		DWG NO: 646.3300	SHEET: 2 OF 8
2 PLACE DECIMALS: ±.01			
3 PLACE DECIMALS: ±.005			
ANGLES: ±.5°			

THE INFORMATION CONTAINED IN THIS DRAWING IS THE SOLE PROPERTY OF APICAL INDUSTRIES, AND EMPLOYERS (CUTTERS) PART OF WHOLE WITHOUT THE WRITTEN PERMISSION OF APICAL INDUSTRIES IS PROHIBITED.

A
B
C
D

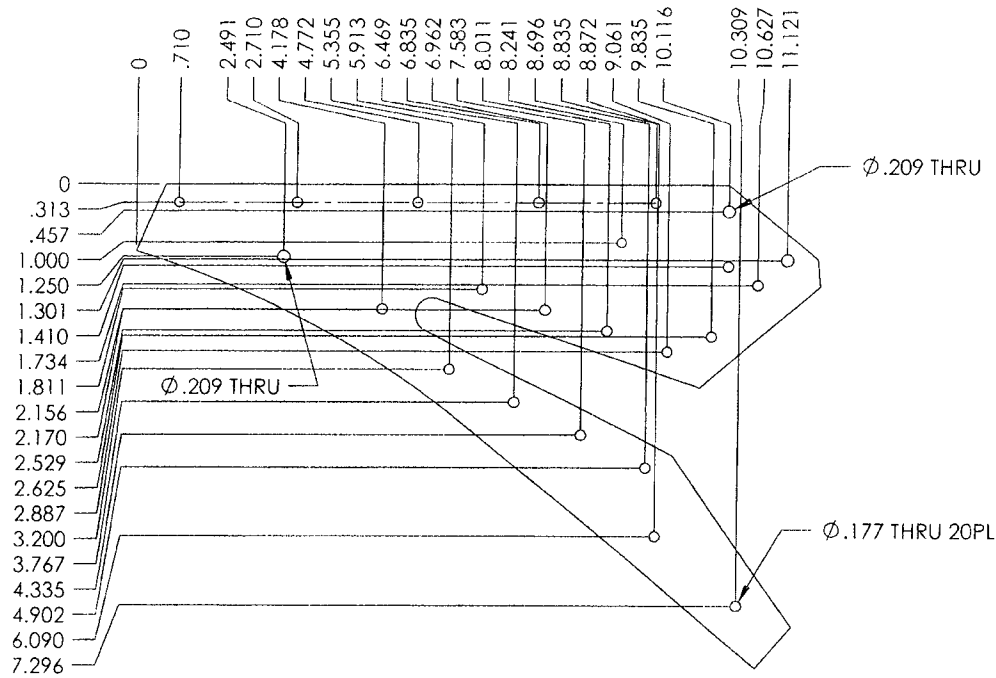


SECTION A-A

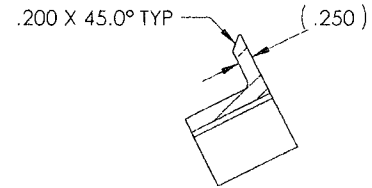

SECTION B-B



ORIGINAL DATE 10-28-00		APICAL INDUSTRIES	
DESIGNITY B		2608 TEMPLE HEIGHTS DR. OCEANSIDE, CA. 92056-3512 (760) 724-5300	
DATE 10-28-00		UPPER CUTTER ASSY	
CONTRACT NO.		646.3300	
UNLESS OTHERWISE SPECIFIED DIMENSIONS ARE IN INCHES TOLERANCES ARE FRACTIONS DECIMALS ANGLES ± .5°		REV. B	REV. NYC
SCALE 1:1000		SHEET 3 OF 8	

REV	DESCRIPTION	DATE	AMOUNT

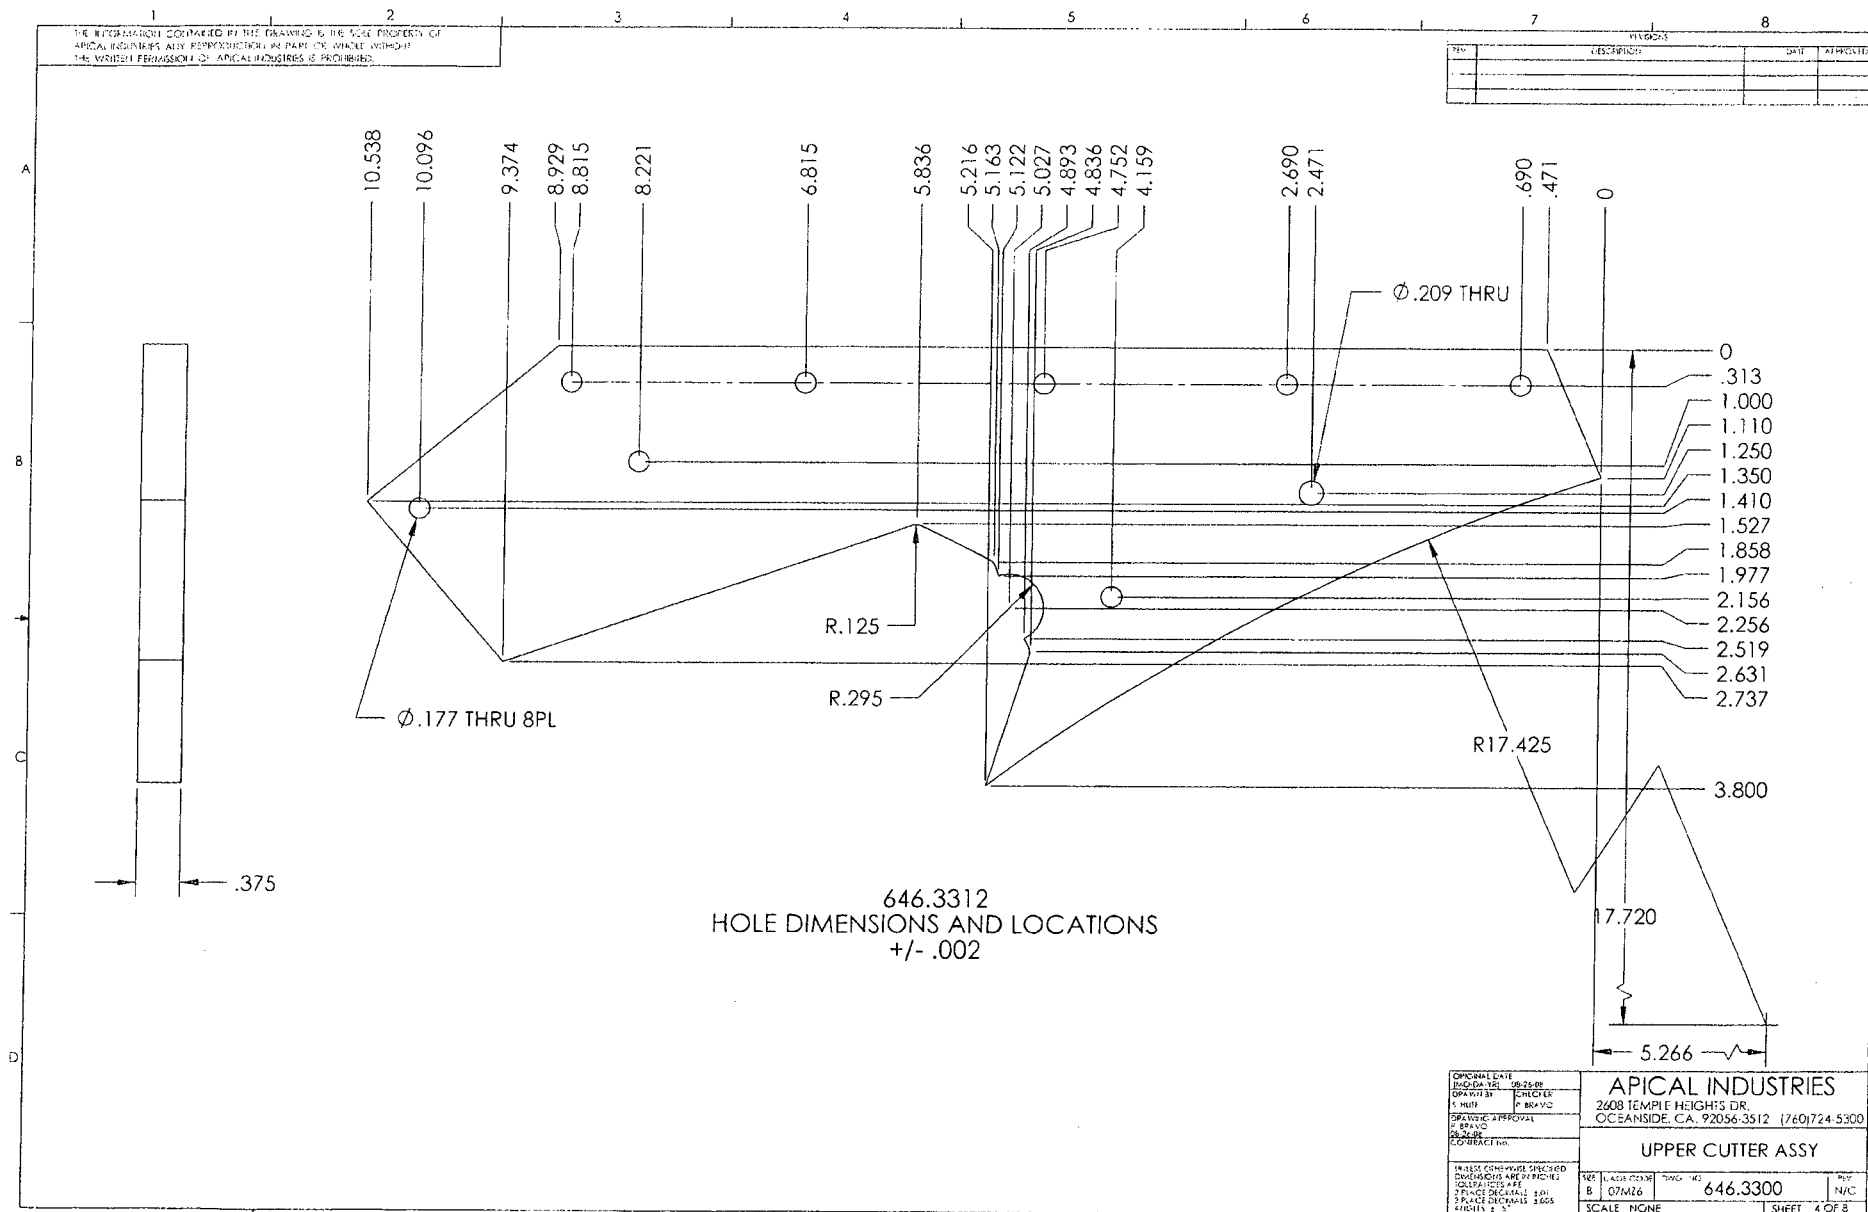


THE INFORMATION CONTAINED IN THIS DRAWING IS THE SOLE PROPERTY OF APICAL INDUSTRIES AND REPRODUCTION IN PART OR WHOLE WITHOUT THE WRITTEN PERMISSION OF APICAL INDUSTRIES IS PROHIBITED.


REV	DESCRIPTION	DATE	APPROVED

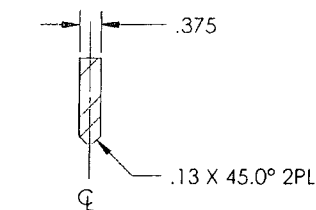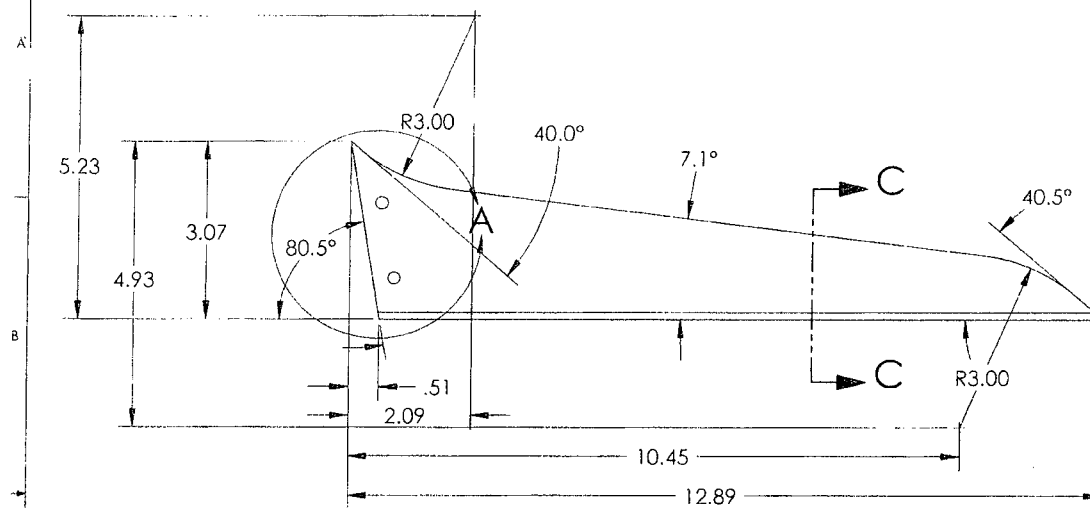

SECTION C-C

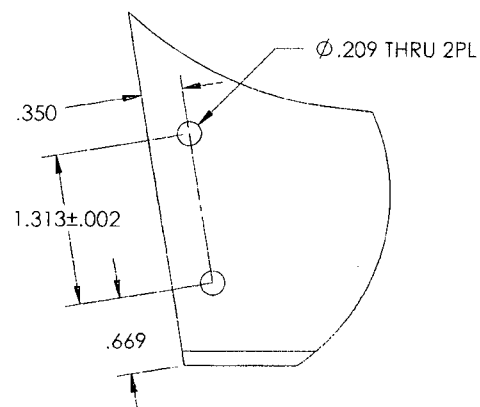

DETAIL A



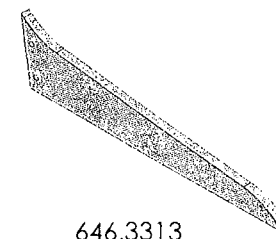


646.3313

ORIGINAL DATE: 08-20-06 DRAWN BY: CHECKED: S. HOFF P. SPANIO DRAWING APPROVAL: P. BRANC J. BROWN CONFIRMATION:		APICAL INDUSTRIES 2608 TEMPLE HEIGHTS DR. OCEANSIDE, CA. 92056-3512 (760)724-5300	
REF: LIST OTHERWISE SPECIFIED DIMENSIONS ARE IN INCHES TOLERANCES ARE: * FRACTIONS DECIMALS ± .01 * DIMENSIONS IN PARENS ± .001 * DIMENSIONS IN PARENS ± .001		SHEET CODE: B DIMS NO: 07M26 SCALE: NONE	SHEET NO: 646.3300 DATE: N/A

THE INFORMATION CONTAINED IN THIS DRAWING IS THE SOLE PROPERTY OF APICAL INDUSTRIES. ANY REPRODUCTION IN PART OR WHOLE WITHOUT THE WRITTEN PERMISSION OF APICAL INDUSTRIES IS PROHIBITED.

REV	DESCRIPTION	DATE	APPROVED

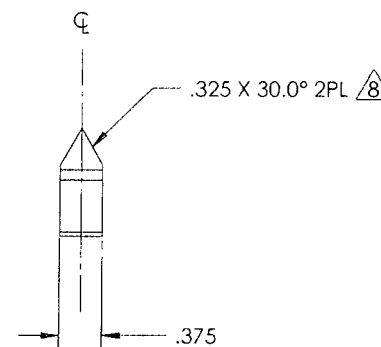
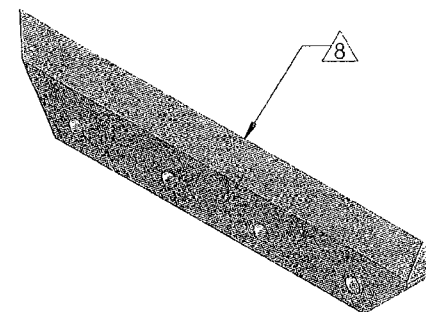
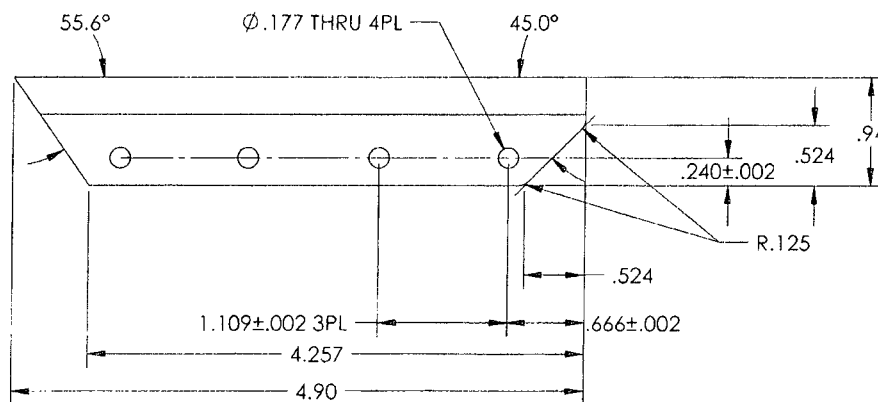


646.3314

ORIGINAL DATE: 06-26-96 DRAWN BY: J. HOFF CHECKED BY: J. HOFF DRAWING APPROVAL: P. HALL M. JONES L. HOFFMAN	APICAL INDUSTRIES 2606 TEMPLE HEIGHTS DR. OCEANSIDE, CA 92056-3512 (760)724-5300
UNLESS OTHERWISE SPECIFIED DIMENSIONS ARE IN INCHES TOLERANCES ARE: FRACTIONS DECIMALS .005 ANGLES .5°	UPPER CUTTER ASSY 646.3300 SCALE: NONE SHEET 6 OF 8

THE INFORMATION CONTAINED IN THIS DRAWING IS THE SOLE PROPERTY OF APICAL INDUSTRIES. ANY REPRODUCTION IN PART OR WHOLE WITHOUT THE WRITTEN PERMISSION OF APICAL INDUSTRIES IS PROHIBITED.

REVISIONS			
REV.	DESCRIPTION	DATE	APPROVED

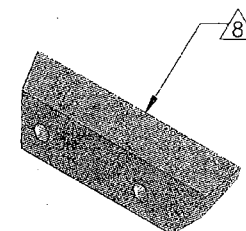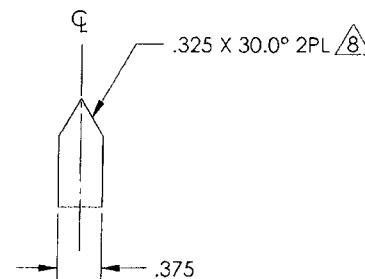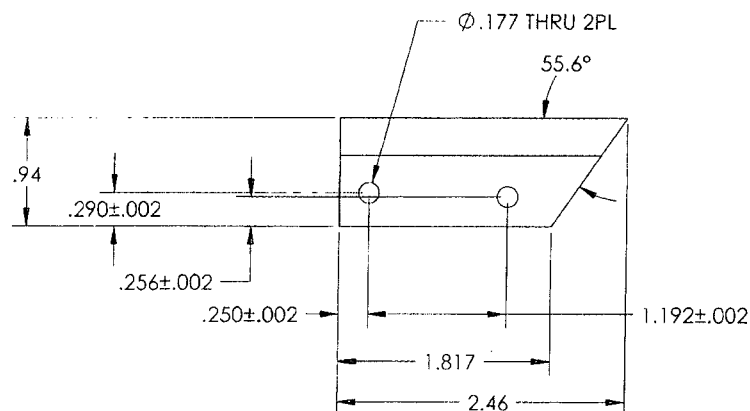


646.3315



ORIGINAL DATE 06/26/00 DRAWN BY J. HART CHECKED BY P. BRAYO ENGINEERING APPROVAL P. BRAYO DATE 06/26/00			
APICAL INDUSTRIES 2600 TEMPLE HEIGHTS DR. OCEANSIDE, CA 92056-3912 (760)724-5350			
UPPER CUTTER ASSY			
PARTS CHANGES REQUIRED DIMENSIONS ARE IN INCHES UNLESS OTHERWISE SPECIFIED TOLERANCES ARE: FRACTIONS DECIMALS INCHES .001 .0005 .0002 .0001 .001 .0005 .0002 .0001	REV B	CAD CODE 07M26	TMR. NO. 646.3300
SCALE NONE	DEV N/C	SHEET 7 OF 8	DATE 06/26/00

THE INFORMATION CONTAINED IN THE DRAWING IS THE SOLE PROPERTY OF APICAL INDUSTRIES AND REPRODUCTION IN PART OR WHOLE WITHOUT THE WRITTEN PERMISSION OF APICAL INDUSTRIES IS PROHIBITED.

REV	DESCRIPTION	DATE	APPROVED

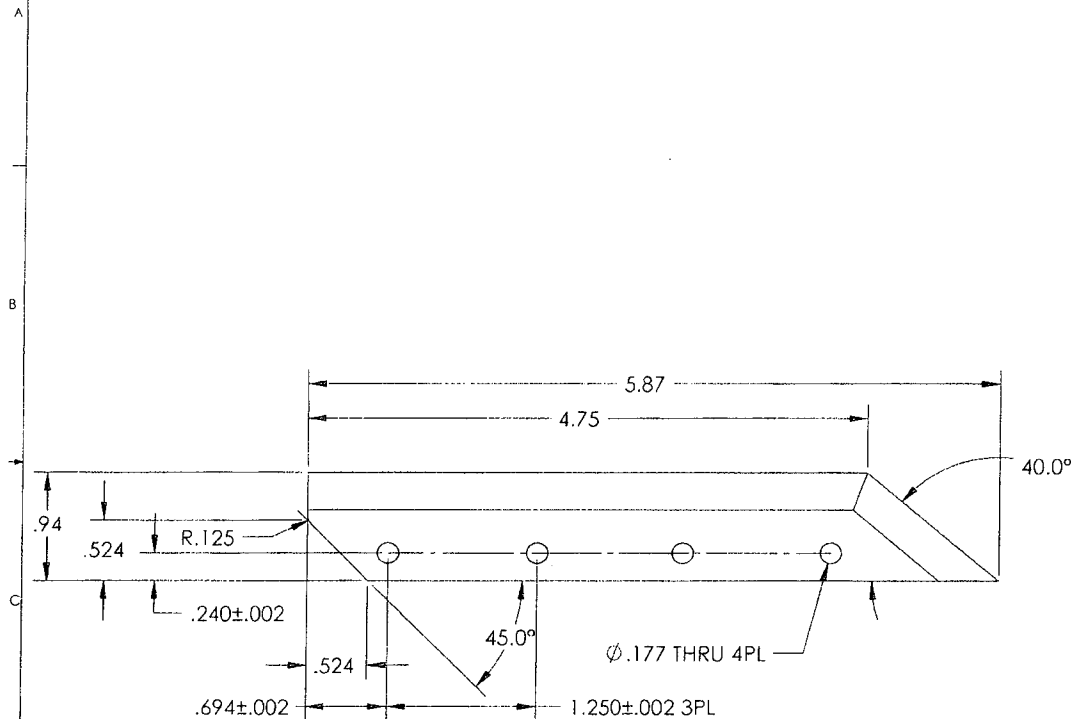

646.3316

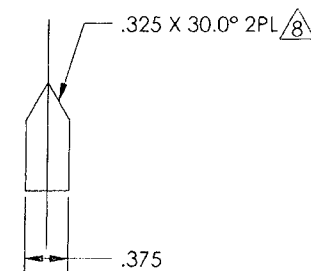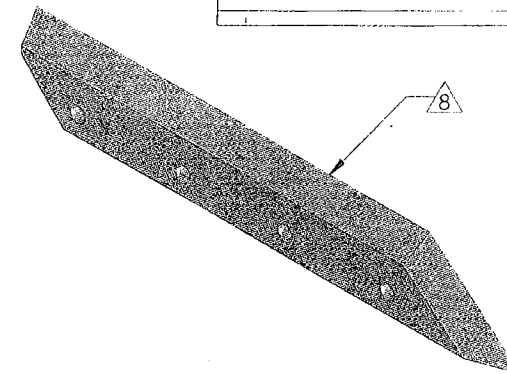

ORIGINAL DATE 10/20/08 DRAWN BY J. BRYAN DRAWING APPROVED J. BRYAN CHECKED J. BRYAN	APICAL INDUSTRIES 2608 TEMPLE HEIGHTS DR. OCEANSIDE, CA, 92056-3512 (760) 724-5300
MATERIALS 304 STAINLESS STEEL DIMENSIONS ARE IN INCHES TOLERANCES ARE: FRACTIONS DECIMALS .001 .001 .001 .001 .001 .001	UPPER CUTTER ASSY 646.3300 SCALE 1:1 SHEET 8 OF 8

METCOR INC.

560 BOUL. ARTHUR-SAUVÉ
ST-EUSTACHE, QC J7R 5A8
Tel: 450-473-1884 / Fax: 450-491-5498

Reçu de livraison


Delivery Receipt

BON DE TRAVAIL Order	EXPÉDITEUR Shipper ID	BON D'EXPÉ Shipper
304925	1	105060

EXPÉDITION COMPLÈTE / Shipped Complete

CLIENT /Customer 215

DART AEROSPACE
1270 ABERDEEN
HAWKESBURY, ON K6A 1K7
Ph: 613-632-5200
Fax: 613-632-1053

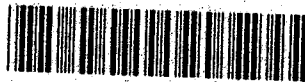

LIVRÉ À / Shipped To

DART AEROSPACE
1270 ABERDEEN
HAWKESBURY, ON K6A 1K7
Ph: 613-632-5200
Fax: 613-632-1053

COMMANDE DU CLIENT Customer PO	BON DE LIVRAISON DU CLIENT Customer Shipper No.	TYPE DE MATÉRIEL Material Type	DATE DE LA COMMANDE Order Date	TRANSPORTEUR Carrier
29729		A2	2015/9/10	fed
QUANTITÉ Quantity	No. PIÈCE Part No.	NOM DE LA PIÈCE Part Name	DESCRIPTION DE LA PIÈCE Part Description	POIDS Weight

10 646.3316

(4) 646.3316 BLADE 135465

(6) 646.3315 BLADE 135584

26,4

1 BOITE DE CARTON

TYPE DE CONTENEUR Container Type	# DE CONTENEURS # Of Containers	COMMENTAIRES CONTENEUR Container Comments
BOITE DE CARTON	1	

CERTIFICAT

EMPAQUETAGE Packing	
------------------------	--

QUANTITÉ EXPÉDIÉE / Quantity Shipped : 10

POIDS EXPÉDIÉ / Weight Shipped : 26,40

QUANTITÉ RESTANTE / Quantity Remaining : 0

POIDS RESTANT / Weight Remaining : 0,00

CERTIFICAT

QUANTITÉ EXPÉDIÉE / Quantity Shipped: 10

POIDS EXPÉDIÉ / Weight Shipped : 26,40

Signature:

Date:

METCOR INC.

560 BOUL. ARTHUR-SAUVÉ, ST-EUSTACHE, QC, J7R 5A8

Tél.: 450-473-1884

Télécopieur / Fax administration: 450-491-5498

Télécopieur / Fax production: 450 491-6454

Certificat de Conformité Détaillé

Detailed Certificate of Compliance

BON DE TRAVAIL order	CHARGEMENT load
304925	1

CLIENT / customer: 215

DART AEROSPACE

1270 ABERDEEN

HAWKESBURY

ON K6A 1K7

LIVRÉ À / shipped to:

DART AEROSPACE

1270 ABERDEEN

HAWKESBURY

ON K6A 1K7

1

COMMANDE DU CLIENT customer po	BON DE LIVRAISON DU CLIENT customer shipper no.	MATÉRIEL material	MAÎTRE D'OEUVRE prime contractor	PROGRAM
29729		A2		
SPECIFICATIONS DU PROCÉDÉ processing specifications				
VAC HARDEN				
HARDEN AND TEMPER				
EXIGENCE / requirement	SPECIFICATIONS / specified		TESTS EXÉCUTÉS / performed	RÉSULTATS DE TESTS / results
HARDNESS	58 - 62 HRC		5	60 - 61 HRC
QUANTITÉ quantity	POIDS weight	DESCRIPTION DES PIÈCES parts description		
10	26.4	646.3316 (4) 646.3316 BLADE 135465 (6) 646.3315 BLADE 135584 1 BOITE DE CARTON		

COMMENTAIRES / comments

VAC HARDEN 1800F, 1:30 HR
DOUBLE TEMPER 400F, 2 HRS

Heat treatment (HT) was performed with equipment that meets the requirements of requested specification. All HT operations were performed in compliance with the required HT specification and all verifications have been performed and documented. No unauthorized changes were performed in regards to the HT. We certify that the material was manufactured, sampled, tested and inspected in accordance with the material specification and the purchase order and was found to meet the requirements.

Le traitement thermique (TT) a été fait en utilisant des équipements en conformité avec la spécification demandée. Toutes les opérations de TT ont été faites en conformité avec les requis de la spécification demandée et toutes les vérifications et les tests demandés ont été faites et documentés. Aucun changement n'a été faite par rapport au TT. On certifie que le matériel a été fabriqué, échantillonné, testé et inspecté en accord avec les spécifications du matériel et le bon de commande et le matériel rencontre les exigences spécifiées.

APPROUVÉ par / Approved by:

Isabel Otero
QA Technician

DATE: 2015-09-14



Dart Aerospace Ltd.
1270 Aberdeen Street
Hawkesbury, ON K6A 1K7
Tel: 613 632 9577
Fax: 613 632 1053

PURCHASE ORDER

Purchase Order ID **PO29729**

Purchase Order Date 9/9/2015

PO Print Date 9/9/2015

Page Number 1 of 2

Order From :

VC-MET004

METCOR INC.
560 BOUL. ARTHUR SAUVE
SAINT-EUSTACHE, QC J7R 5A8
CA

Ship To : DART AEROSPACE LTD
1270 ABERDEEN
HAWKESBURY, ON K6A 1K7
CANADA

Contact Name

Vendor Phone 450 473 1884

Ship To Contact

Ship To Phone

Ship Via: FedEx Overnight collect

Ship Acct:

Buyer

Chantal Lavoie

Customer POID

Customer Tax # 10127-2607

Terms Net 30

Currency CAD

FOB FCA - (Free Carrier)

Line Nbr	Reference Vendor Part Number Line Comments Delivery Comments	Description/ Mfg ID	Req Date/ Taxable Promise Date	CD	Req Qty/ Unit of Measure	PO Unit Price	Extended Price
----------	---	------------------------	--------------------------------------	----	--------------------------------	---------------	-------------------

1	135465	646.3316 BLADE	9/21/2015 Yes 9/21/2015		4.00 /	\$0.00	\$0.00
---	--------	----------------	-------------------------------	--	--------	--------	--------

FINISH: HEAT TREAT TO 58-62 RC
ROCKWELL HARDNESS

PART ARE MADE FROM AISI A2 TOOL STEEL

PLEASE NOTE: DETAIL C OF C REQUIRED

Line Total: \$0.00

2	135584	646.3315 BLADE	9/21/2015 Yes 9/21/2015		6.00 / 15/9/16 50	\$0.00	\$0.00
---	--------	----------------	-------------------------------	--	-------------------------	--------	--------

FINISH: HEAT TREAT TO 58-62 RC
ROCKWELL HARDNESS

PART ARE MADE FROM AISI A2 TOOL STEEL

PLEASE NOTE: DETAIL C OF C REQUIRED

Note:

9/9/2015



Dart Aerospace Ltd.
1270 Aberdeen Street
Hawkesbury, ON K6A 1K7
Tel: 613 632 9577
Fax: 613 632 1053

PURCHASE ORDER

Purchase Order ID **PO29729**

Purchase Order Date 9/9/2015

PO Print Date 9/9/2015

Page Number 2 of 2

Order From :

VC-MET004

METCOR INC.
560 BOUL. ARTHUR SAUVE
SAINT-EUSTACHE, QC J7R 5A8
CA

Ship To : DART AEROSPACE LTD
1270 ABERDEEN
HAWKESBURY, ON K6A 1K7
CANADA

Contact Name

Vendor Phone 450 473 1884

Ship To Contact

Ship To Phone

Ship Via: FedEx Overnight collect

Ship Acct:

Buyer

Chantal Lavoie

Customer POID

Customer Tax #

10127-2607

Terms

Net 30

Currency

CAD

FOB

FCA - (Free Carrier)

Line Total: \$0.00

3	71401-45	PROCUREMENT QUALITY CLAUSES	9/21/2015	1.00	\$0.00	\$0.00
---	----------	--------------------------------	-----------	------	--------	--------

No

Procurement Quality Clauses

9/21/2015

A005 right of entry

A012 chemical and physical test report

A020 non-destructive test/inspection identification

A021 dart aerospace processing

A024 process certifications

A026 certification of material conformance

Line Total: \$0.00

PO Total: \$0.00

Note: Terms & Condition of Purchasing(Suppliers) and Procurement Quality Clauses are an integral part of our AS9100 requirements. To learn in detail, please visit www.dartaerospace.com for further explanation.

Change Nbr: 1

Change Date: 9/9/2015